


BBH Pty Ltd (ACN 010 427 531), hereby certify that the details shown on this plan and associated dataset are a true representation of our field survey for this site.

*[Signature]*  
Director Cadastral Surveyor      Director

Date 23-12-2020

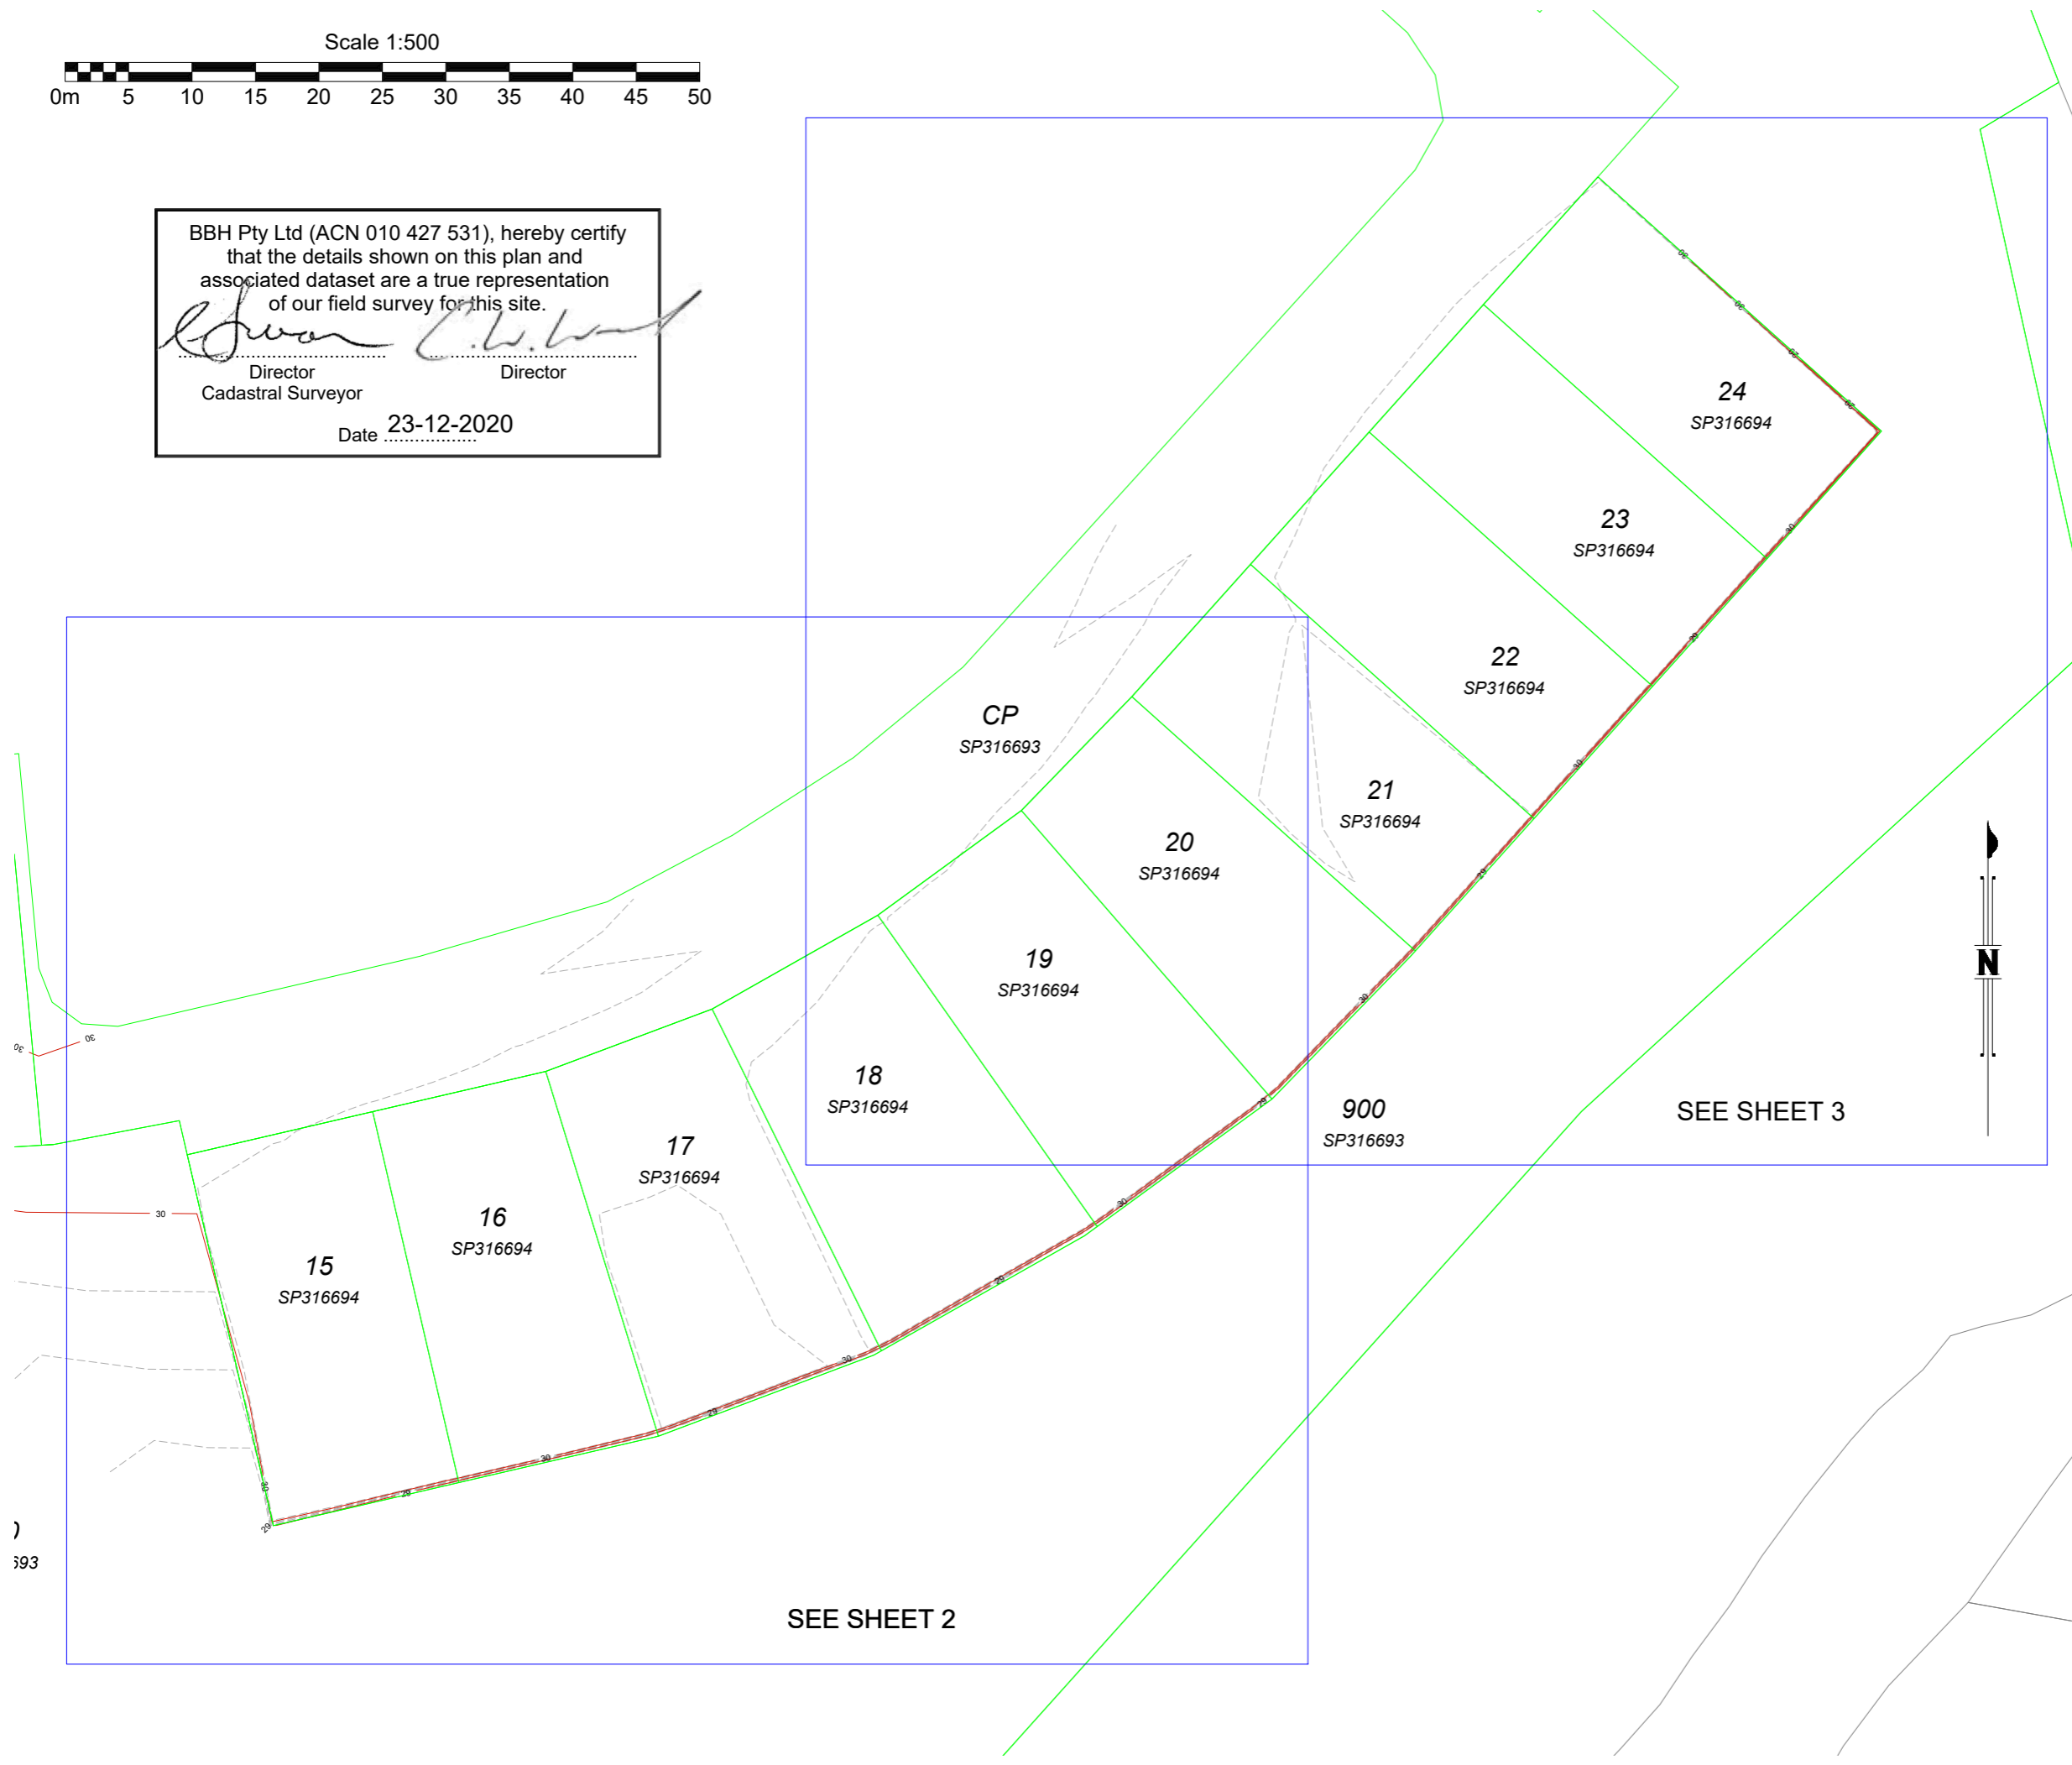

NOTES:


1. Drawn to scale on an A3 sheet.
3. All levels are in metres on the Australian Height Datum referred to PM106537- RL 29.906m AHD situated at McDowall Bridge, Everton Park
7. Field Survey Completed on 17/12/2020

Level datum: AHD Derived (PSM106537)  
Horiz datum: PLAN (IS220713)  
Coord Origin: GNSS (Truncated MGA System to match Engineering design v  
GDA System: GDA94 Coordinate System: Plane 1:1  
Meridian: + 0°00' IS220713

Title:

**Plan of Stage 3**  
**As Constructed Lot Levels**  
**Ashford Residences, Everton Park**

Client:	<b>The Mirvac Group</b>		
Locality:	Everton Park		
Local Gov:	Brisbane City Council		
Surveyed By:	CTN	Approved:	BWM
Date Created:	23/12/20	Scale:	1:500
File Ref:	191518		
Plan No:	<b>191518_048_ASC</b>	Rev:	<b>A</b>

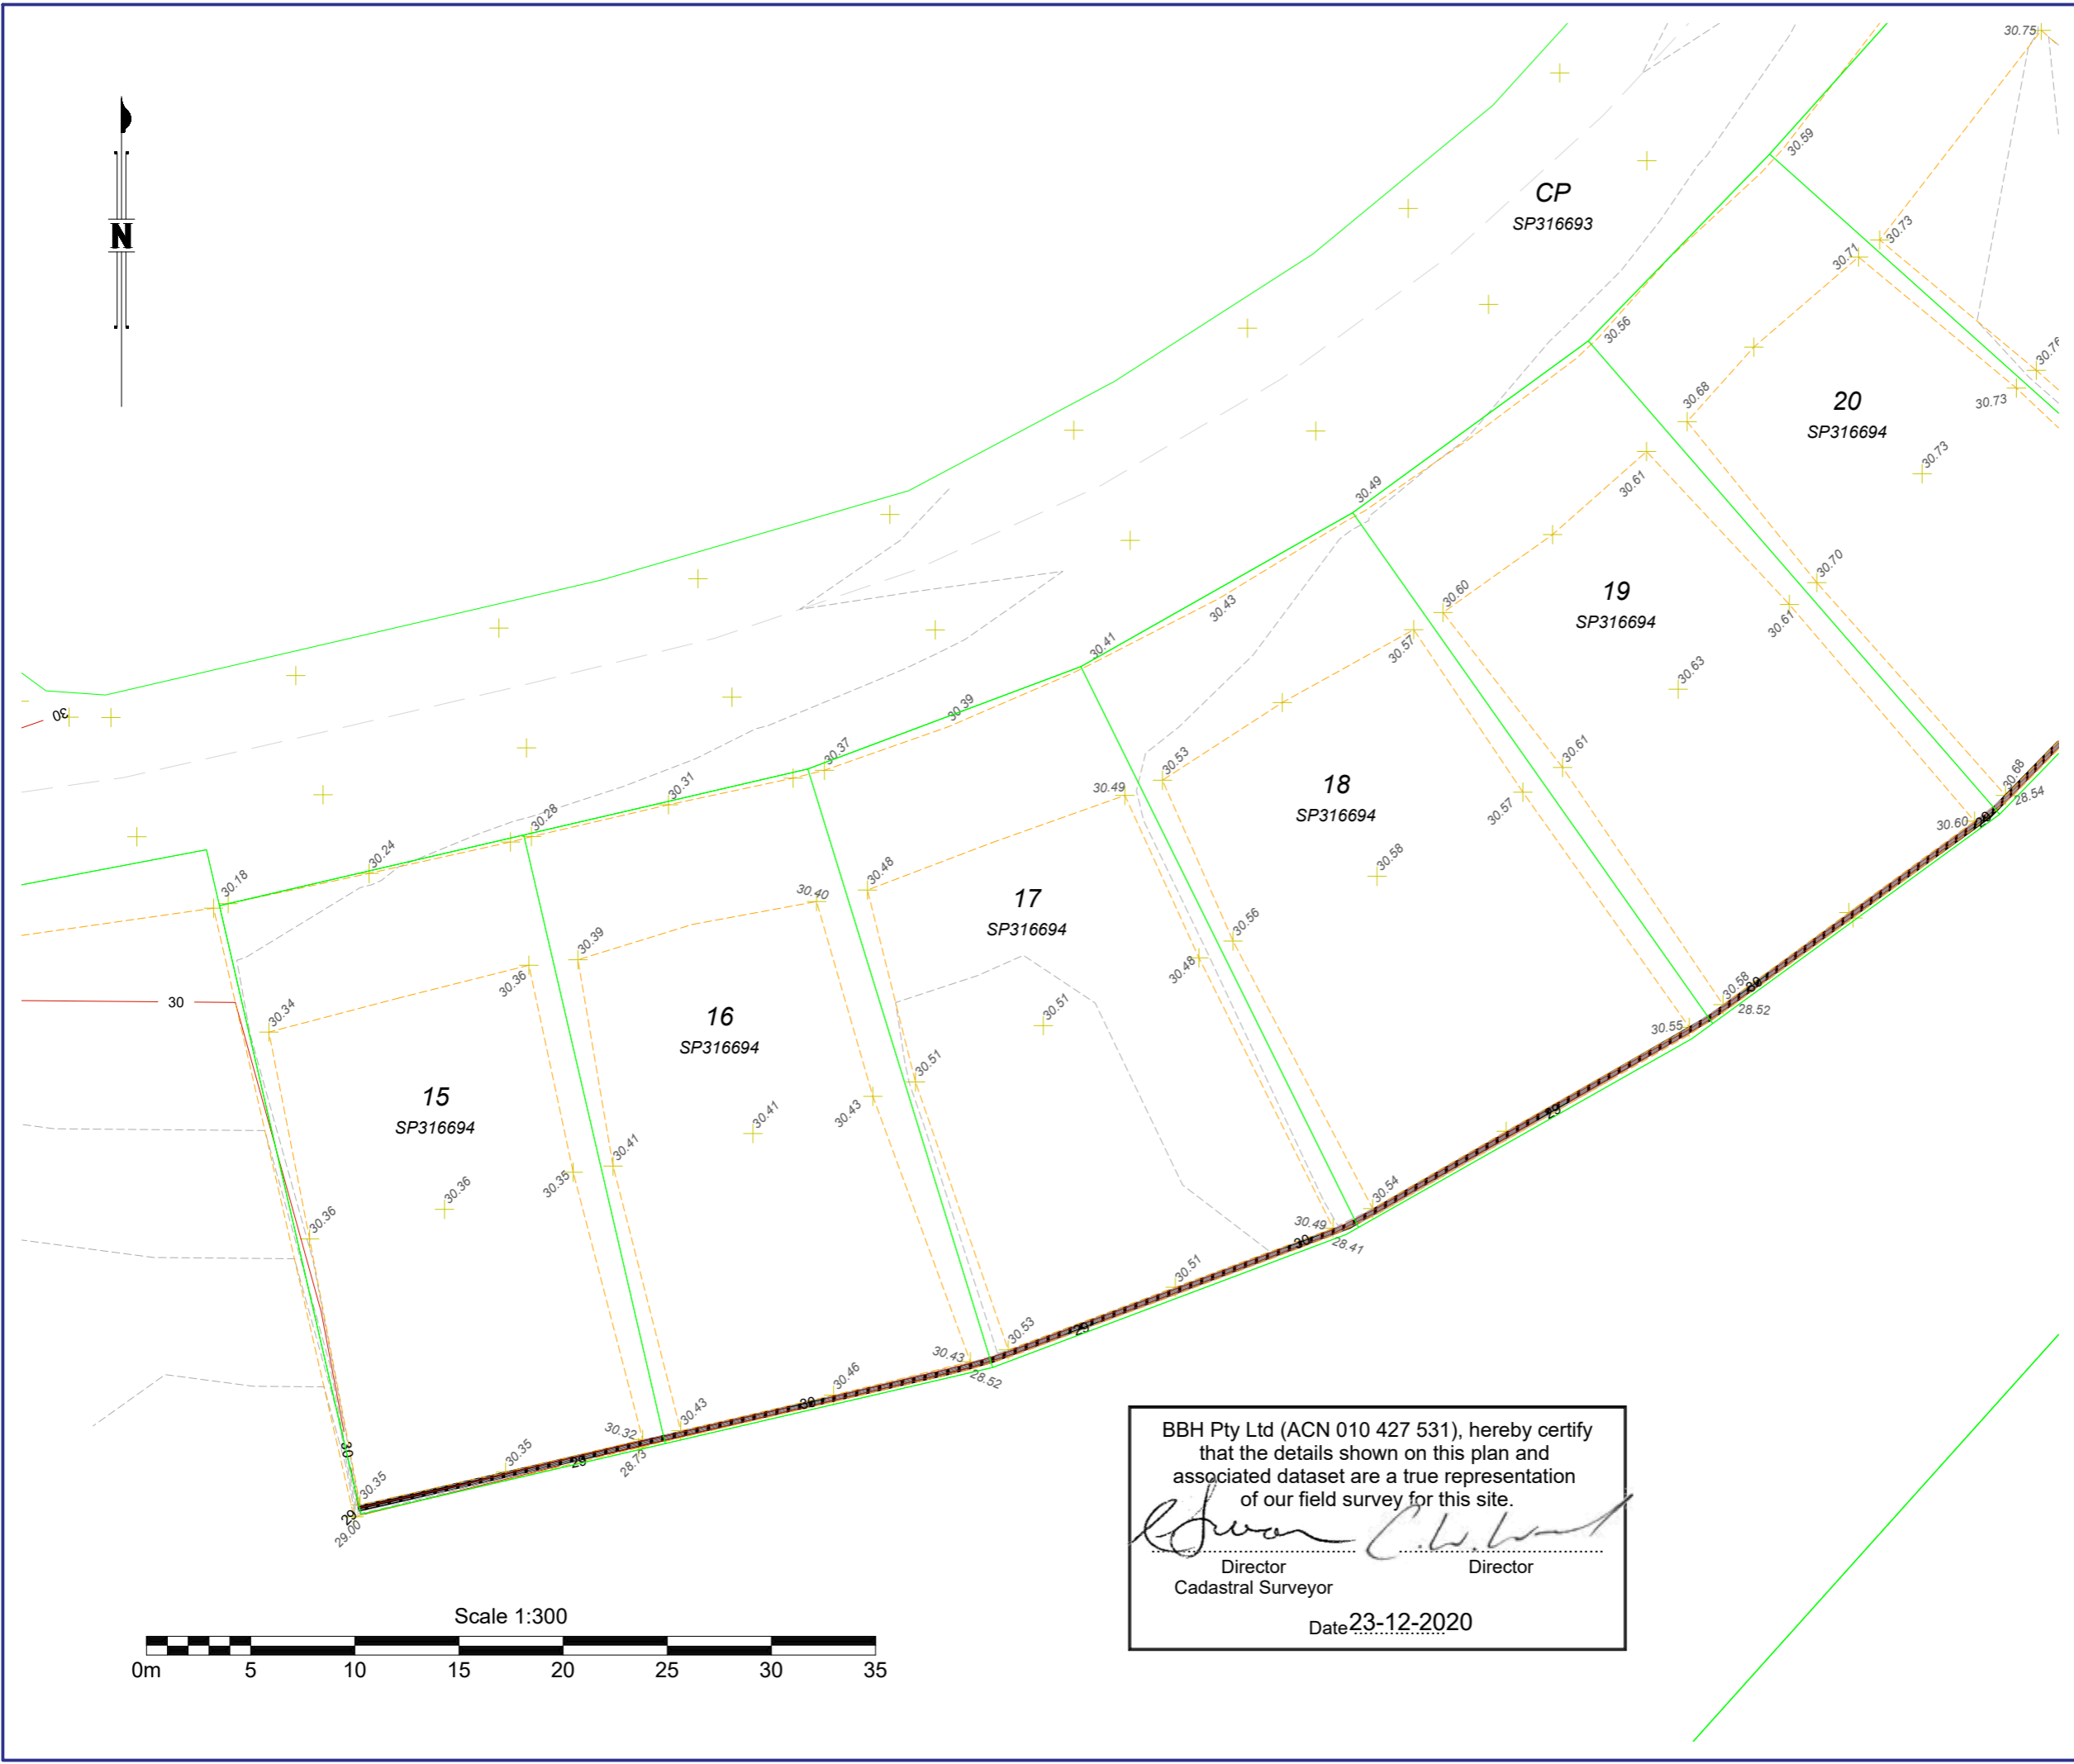

- NOTES:
1. Drawn to scale on an A3 sheet.
  3. All levels are in metres on the Australian Height Datum referred to PM106537- RL 29.906m AHD situated at McDowall Bridge, Everton Park
  7. Field Survey Completed on 17/12/2020

Level datum: AHD Derived (PSM106537)  
Horiz datum: PLAN (IS220713)  
Coord Origin: GNSS (Truncated MGA System to match Engineering design)  
GDA System: GDA94 Coordinate System: Plane 1:1  
Meridian: + 0°00' IS220713

Title:  
**Plan of Stage 3**  
**As Constructed Lot Levels**  
**Ashford Residences, Everton Park**

Client:	<b>The Mirvac Group</b>
Locality:	Everton Park
Local Gov:	Brisbane City Council
Surveyed By:	CTN
Approved:	BWM
Date Created:	23/12/20
Scale:	1:300
File Ref:	191518
Plan No:	<b>191518_048_ASC</b>
Rev:	<b>A</b>

BBH Pty Ltd (ACN 010 427 531), hereby certify that the details shown on this plan and associated dataset are a true representation of our field survey for this site.

*[Signature]*  
Director  
Cadastral Surveyor

Director  
Date **23-12-2020**

